


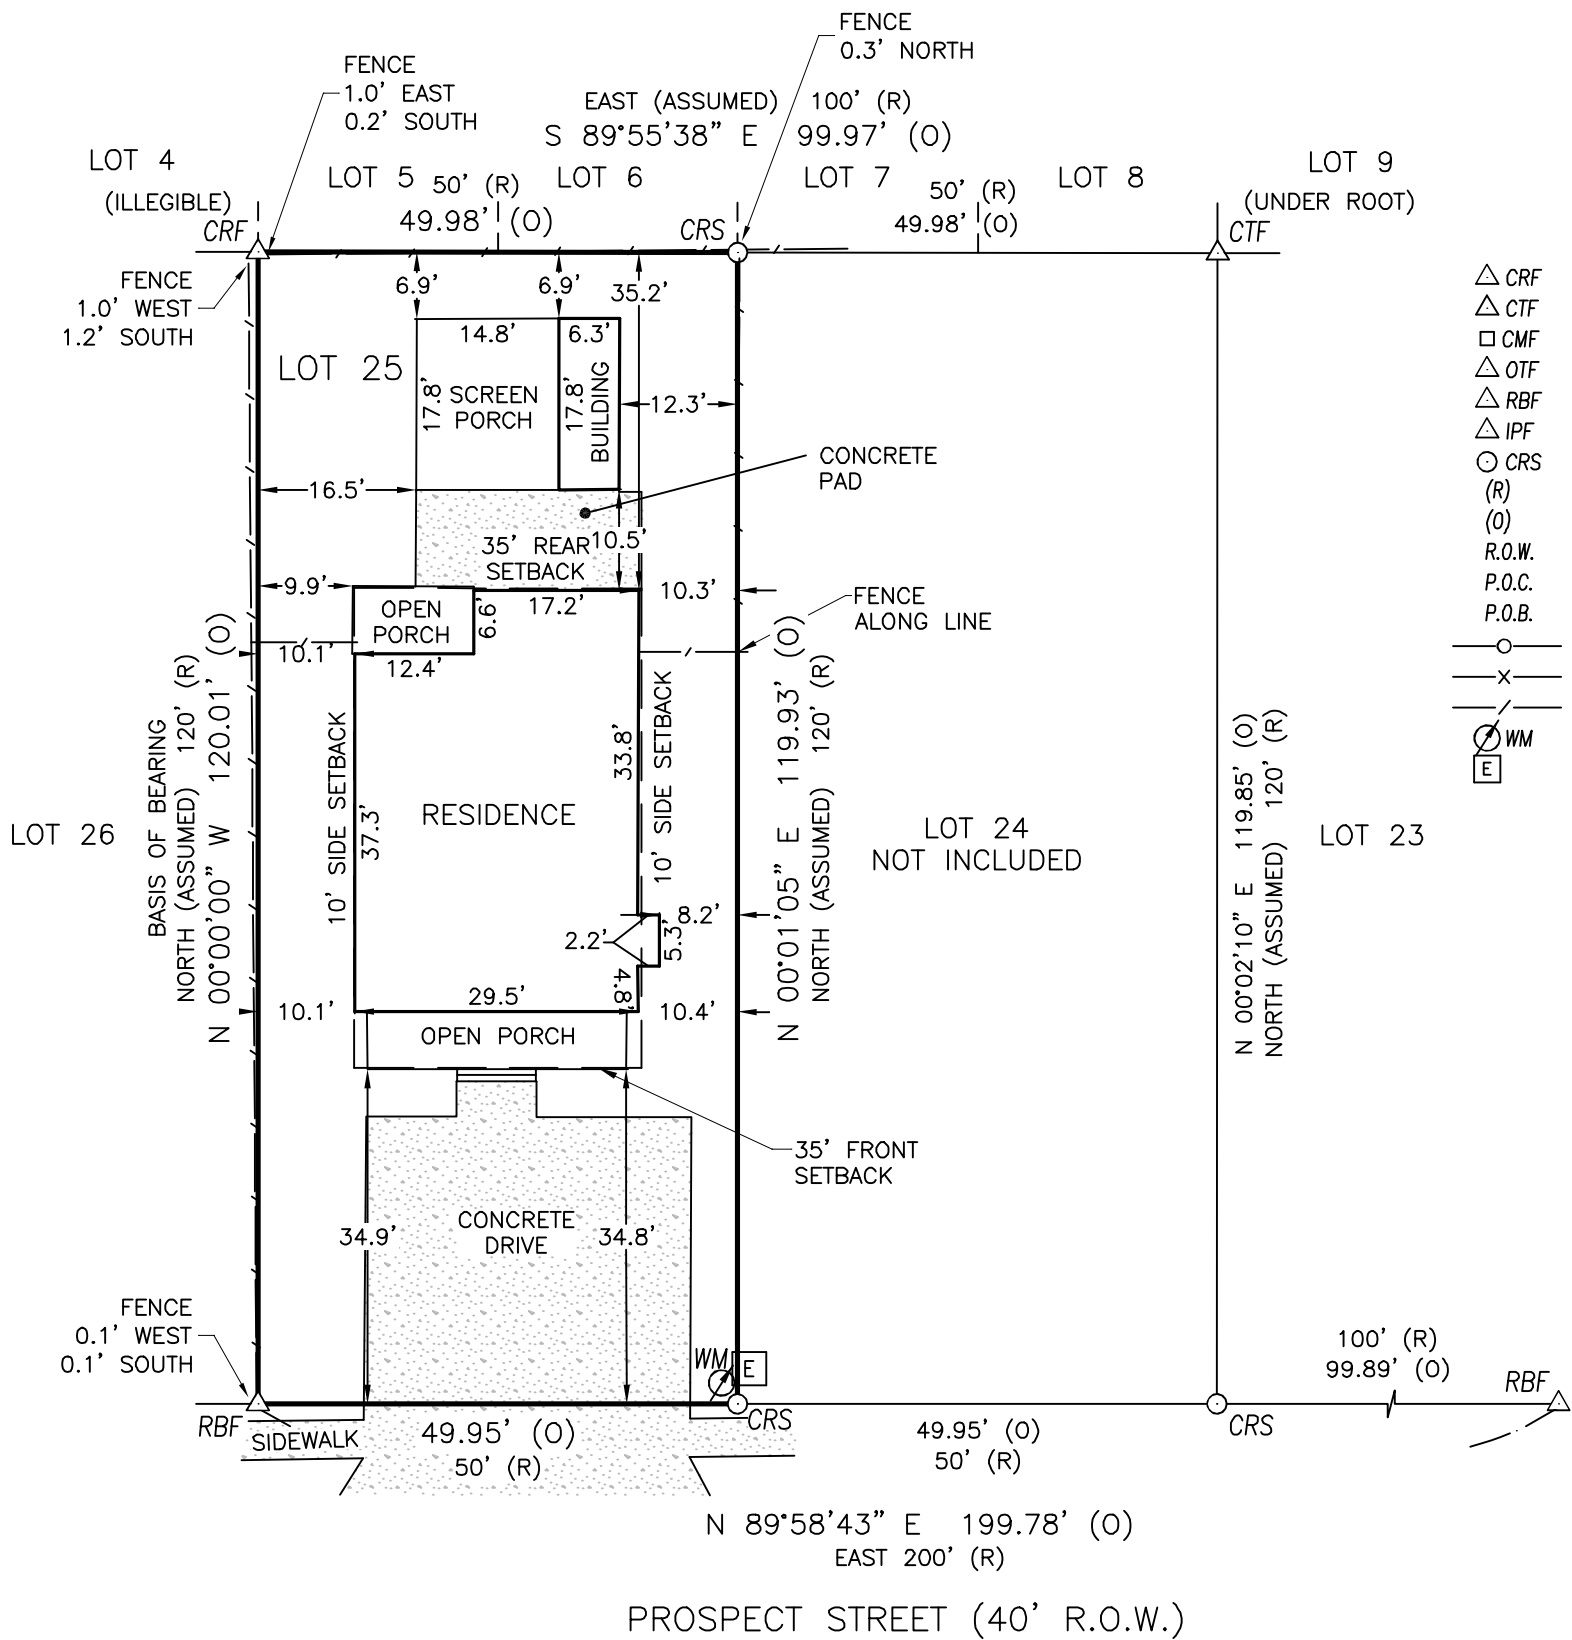

BALDWIN COUNTY
ALABAMA

LOT 25, BLOCK 1, INGLESIDE HIGHLANDS AS RECORDED IN MAP BOOK 1, PAGE 72 IN THE
OFFICE OF THE JUDGE OF PROBATE, BALDWIN COUNTY, ALABAMA.

I HEREBY CERTIFY THAT ALL PARTS OF THIS SURVEY AND DRAWING HAVE BEEN COMPLETED
IN ACCORDANCE WITH THE CURRENT REQUIREMENTS OF THE STANDARDS OF PRACTICE FOR
SURVEYING IN THE STATE OF ALABAMA TO THE BEST OF MY KNOWLEDGE, INFORMATION,
AND BELIEF.

[Signature]

Daniel Clark
ALABAMA LICENSE # 27720
2023.12.03 11:41:18-06'00'

NOTES:

1. TYPE OF SURVEY: AS BUILT
2. RECORD DIMENSIONS BASED ON PLAT OF SUBDIVISION RECORDED IN MAP BOOK 1, PAGE 72
AND ALSO SLIDE 38-A IN THE OFFICE OF THE JUDGE OF PROBATE, BALDWIN COUNTY, ALABAMA.
3. THIS DRAWING AND DESCRIPTION DOES NOT REFLECT ANY TITLE OR EASEMENT RESEARCH OTHER
THAN WHAT IS VISIBLE OR PROVIDED BY THE CLIENT'S CONVEYANCE, SETBACK LINES
ESTABLISHED BY STATUTE, ORDINANCE OR RESTRICTIVE COVENANTS ARE NOT SHOWN.
4. THIS DRAWING IS THE PROPERTY OF SMITH, CLARK & ASSOCIATES. IT IS SOLELY FOR THE USE
OF THE CLIENT NAMED HEREON AND IS NONTRANSFERABLE TO ANY OTHER PARTY, IT MAY NOT
BE USED WITHOUT PRIOR CONSENT FROM SMITH, CLARK & ASSOCIATES.
5. THIS DRAWING IS TO SCALE WHEN PRINTED ON 11X17 PAPER IN PORTRAIT VIEW WITH NO
SCALING.

PARTY CHIEF:	DRAWN:	CHECKED:	CLIENT:
LC	DW	TS	ARK BUILDERS, LLC
DATE:	SCALE:	TITLE:	
11/22/23	1"=20'	AS BUILT SURVEY	
DRAWING NUMBER:	FB/PG:	LOT 25 INGLESIDE HIGHLANDS	
22-122	198/11	FAIRHOPE, ALABAMA	



Physical Address:
11111 U.S. Hwy 31 Ste A
Spanish Fort, AL 36527
(251) 626-0404

SMITH CLARK & ASSOCIATES
land surveyors

Mailing Address:
30941 Mill Lane
Suite G, Box 258
Spanish Fort, AL 36527

