
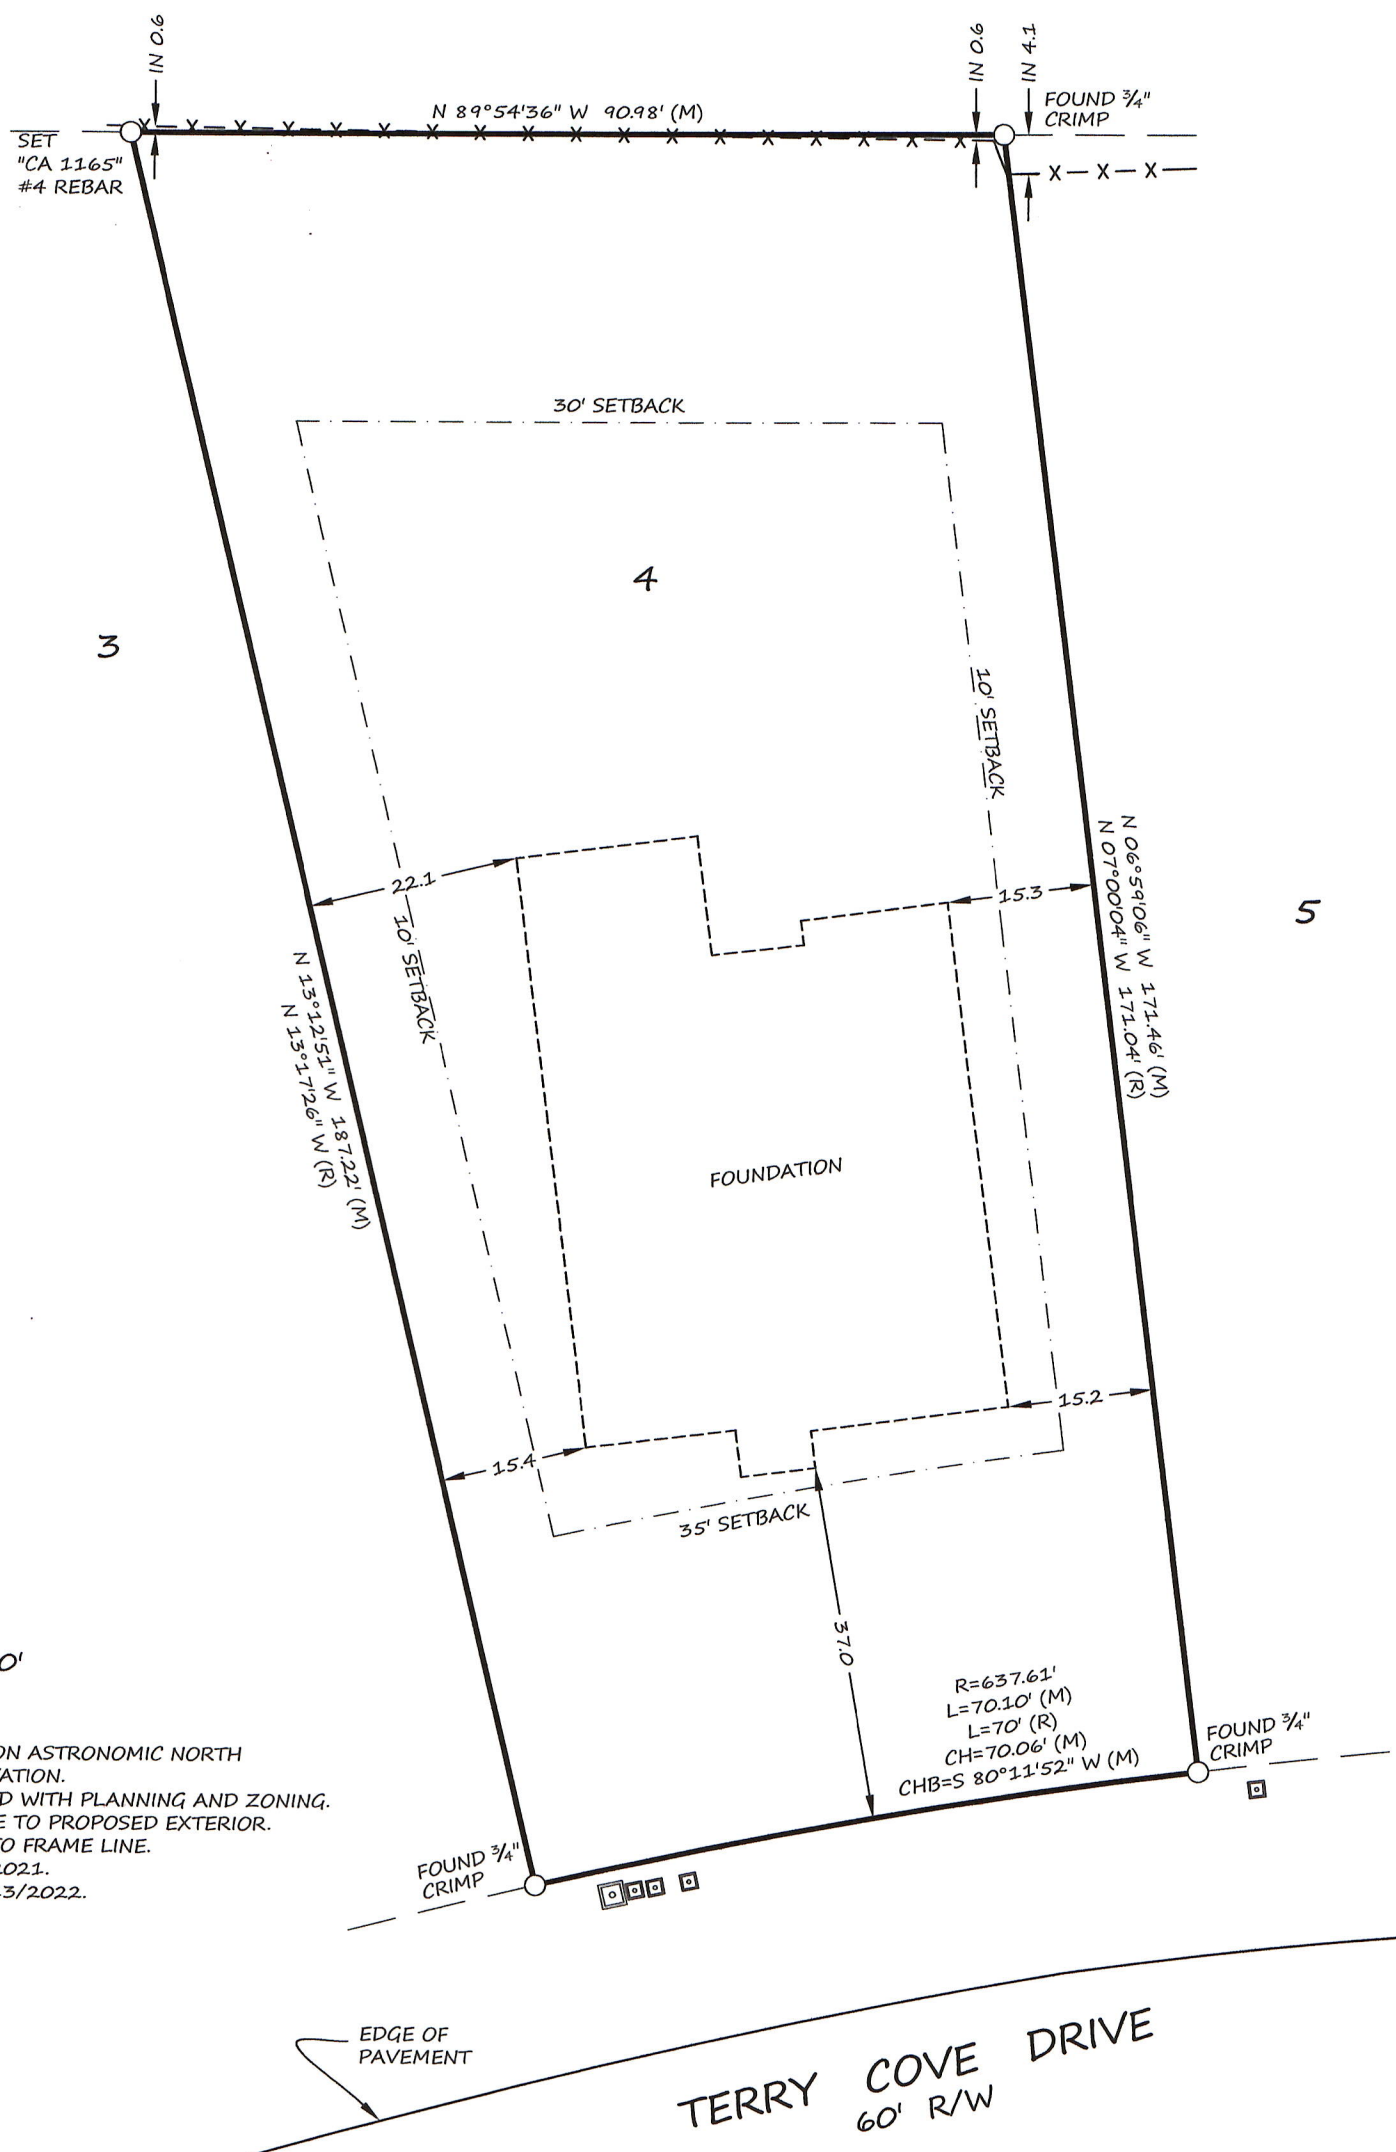


|                    |                        |
|--------------------|------------------------|
| BLDG               | BUILDING               |
| CALC               | CALCULATED             |
| CH                 | CHORD                  |
| D                  | DELTA                  |
| MH                 | MANHOLE                |
| R                  | RADIUS                 |
| R/W                | RIGHT OF WAY           |
| S.F.               | SQUARE FEET            |
| A/C                | AIR CONDITIONER        |
| ●                  | UTILITY POLE           |
| —                  | ANCHOR                 |
| —                  | WALL                   |
| CONC               | CONCRETE               |
| W                  | WATER METER            |
| S                  | SEWER BOX              |
| ⊗                  | IRRIGATION CONTROL BOX |
| ⊗                  | WATER VALVE            |
| ⊗                  | FIRE HYDRANT           |
| ⊗                  | UTILITY BOX            |
| ⊗                  | LIGHT POLE             |
| △                  | STAKING POINT          |
| (M)                | MEASURED               |
| (R)                | RECORDED               |
| CM                 | CONCRETE MONUMENT      |
| FENCE              | — X —                  |
| OVERHEAD UTILITIES | — // —                 |

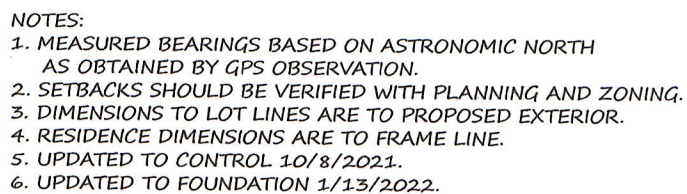


### As-built Survey

Order No.: 5786  
Client: \_\_\_\_\_  
Address: 26117 Terry Cove Drive

Trent Wilson PLS #34764  
Weygand Wilson Surveying LLC  
229 E. 20th Ave., Suite 12  
Gulf Shores, AL 36542  
Phone: (251)-975-7555

**WEYGAND  
WILSON**  
SURVEYORS

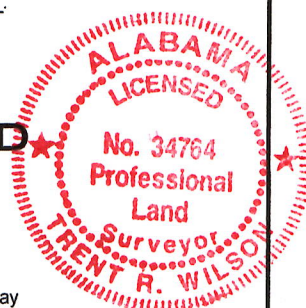

(a) No title search of the public records or abstract of title has been performed by this firm. The parcel shown hereon is subject to setbacks, zoning, easements, rights or way and/or restrictions whether or not of record.

(b) Underground portions of foundations, footings, and/or other underground structures, utilities, cemeteries or burial sites were not located unless otherwise noted.

(c) This survey is intended for the sole use of the client shown hereon, valid for a period of 6 years from the date of survey and non-transferable.