


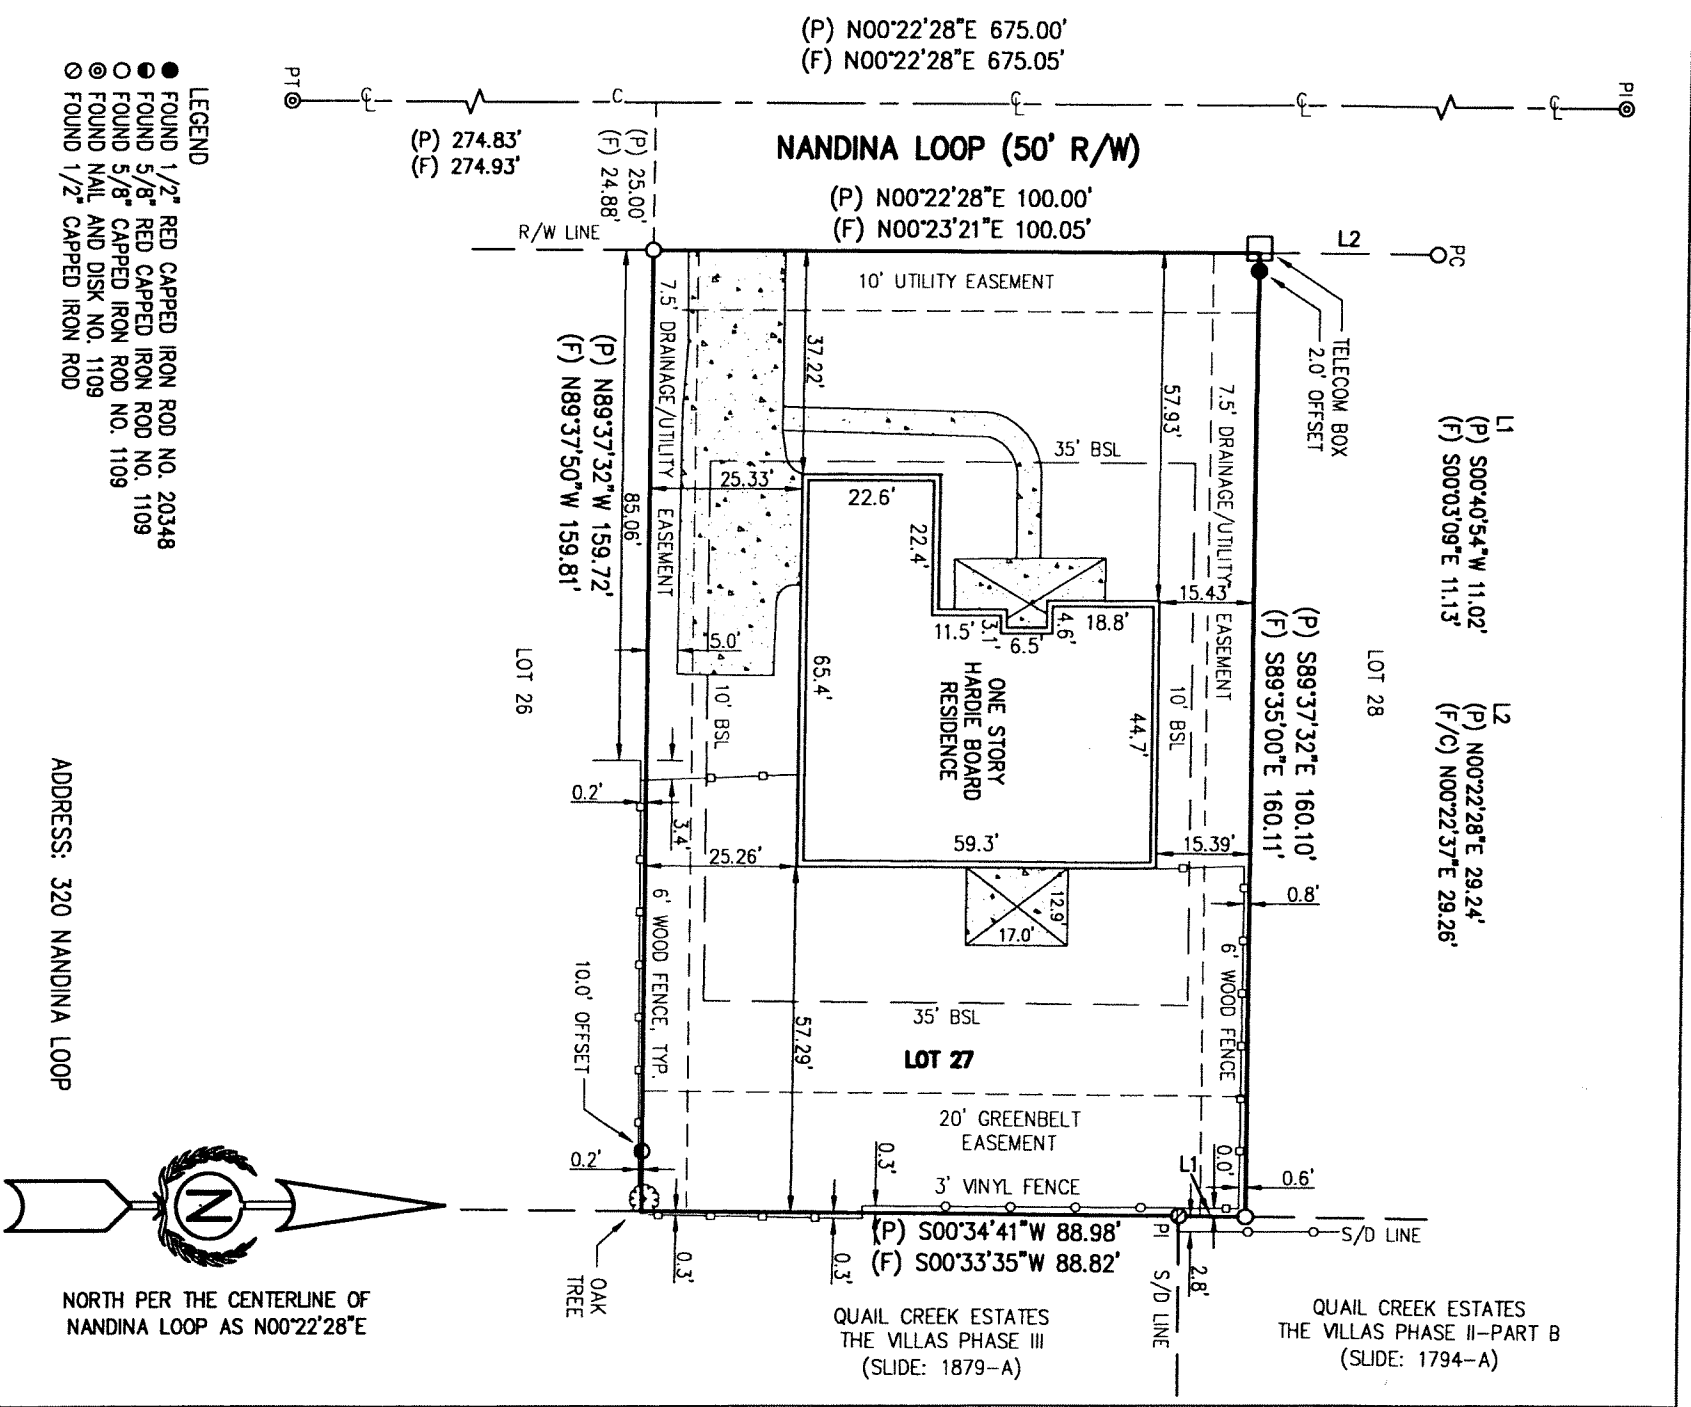

Lands shown hereon were not abstracted for easements and/or right of way recorded of unrecorded by this firm. No search of the public records has been made by this firm to determine any defects and/or ambiguities in the title. Underground portions of foundations, footings, or any other underground structures were not located unless otherwise noted. Measurements were taken in accordance with United States Surveying is subject to setbacks, easements and restrictions of record. This drawing only reflects setback lines which appear on the recorded plat. This property may also be subject to setback lines mandated by zoning ordinances and/or restrictive covenants of record. This survey and/or sketch does not reflect or determine ownership. Federated and State copyright acts protect this survey and/or sketch from unauthorized use. This map is not to be copied or reproduced in whole or part and is not to be used for any other transaction. This survey and/or sketch cannot be used for the benefit of any other person, company or firm without prior written consent of the copyright owner and is to be returned upon request.

DESCRIPTION: LOT 27 GOLDEN OAK AT FIRETHORNE PHASE 4 being a portion of BALDWIN County, Alabama according to Plat recorded in SLIDE 2043-E in the records of the Judge of Probate of said County.

CERTIFICATE					
I HEREBY STATE THAT ALL PARTS OF THIS SURVEY AND DRAWING HAVE BEEN COMPLETED IN ACCORDANCE WITH THE CURRENT REQUIREMENTS OF THE STANDARDS AND PRACTICE FOR LAND SURVEYING IN THE STATE OF ALABAMA TO THE BEST OF MY KNOWLEDGE, INFORMATION, BELIEF.					
REVISIONS	ISSUE DATE	FIELD DATE	F.B./P.G.	DRAWN BY	
BOUNDARY/CONST. LAYOUT	01/03/19	01/02/19	1856/75.76	AN	
AS-BUILT	03/19/20	03/18/20	1841/61	HW	
SCALE 1"=30'	TYPE	PLAT PLAN	ISSUE DATE 12/19/18	FIELD DATE N/A	ORDER NO. 18-12-501
					FIELD BOOK N/A
					DRAWN BY PLG
					Certificate No. CA-0527-LS

Butler & Associates of Pensacola, Inc. 2420 East Olive Road, Suite "A", Pensacola, FL 32514
PROFESSIONAL SURVEYORS AND MAPPERS
Commercial • Residential • Boundary • Topographic • Mortgage Surveys
PENSACOLA
(850) 476-4768
Fax: (850) 476-4945