


BALDWIN COUNTY, ALABAMA
JUDGE ADRIAN T. JOHNS
Filed/ent. 07/20/2008 9:34 AM
TOTAL \$ 23.00
1 Pages


1120386

REVISIONS	BY

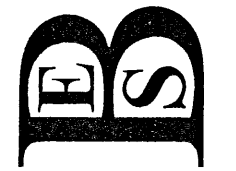


Borden Engineering & Surveying Company, Inc.

8275 Hwy 59 South, Suite 1
Foley, Alabama 36535
Phone: (251) 943-1424
Fax: (251) 943-1427

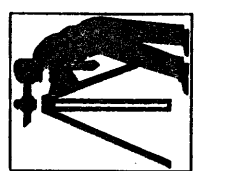


DRAWN	GMM
CHECKED	RCB
DATE	06-06-08
SCALE	1" = 60'
JOB NO.	D - 00045
SHEET	CIVIL PLAN

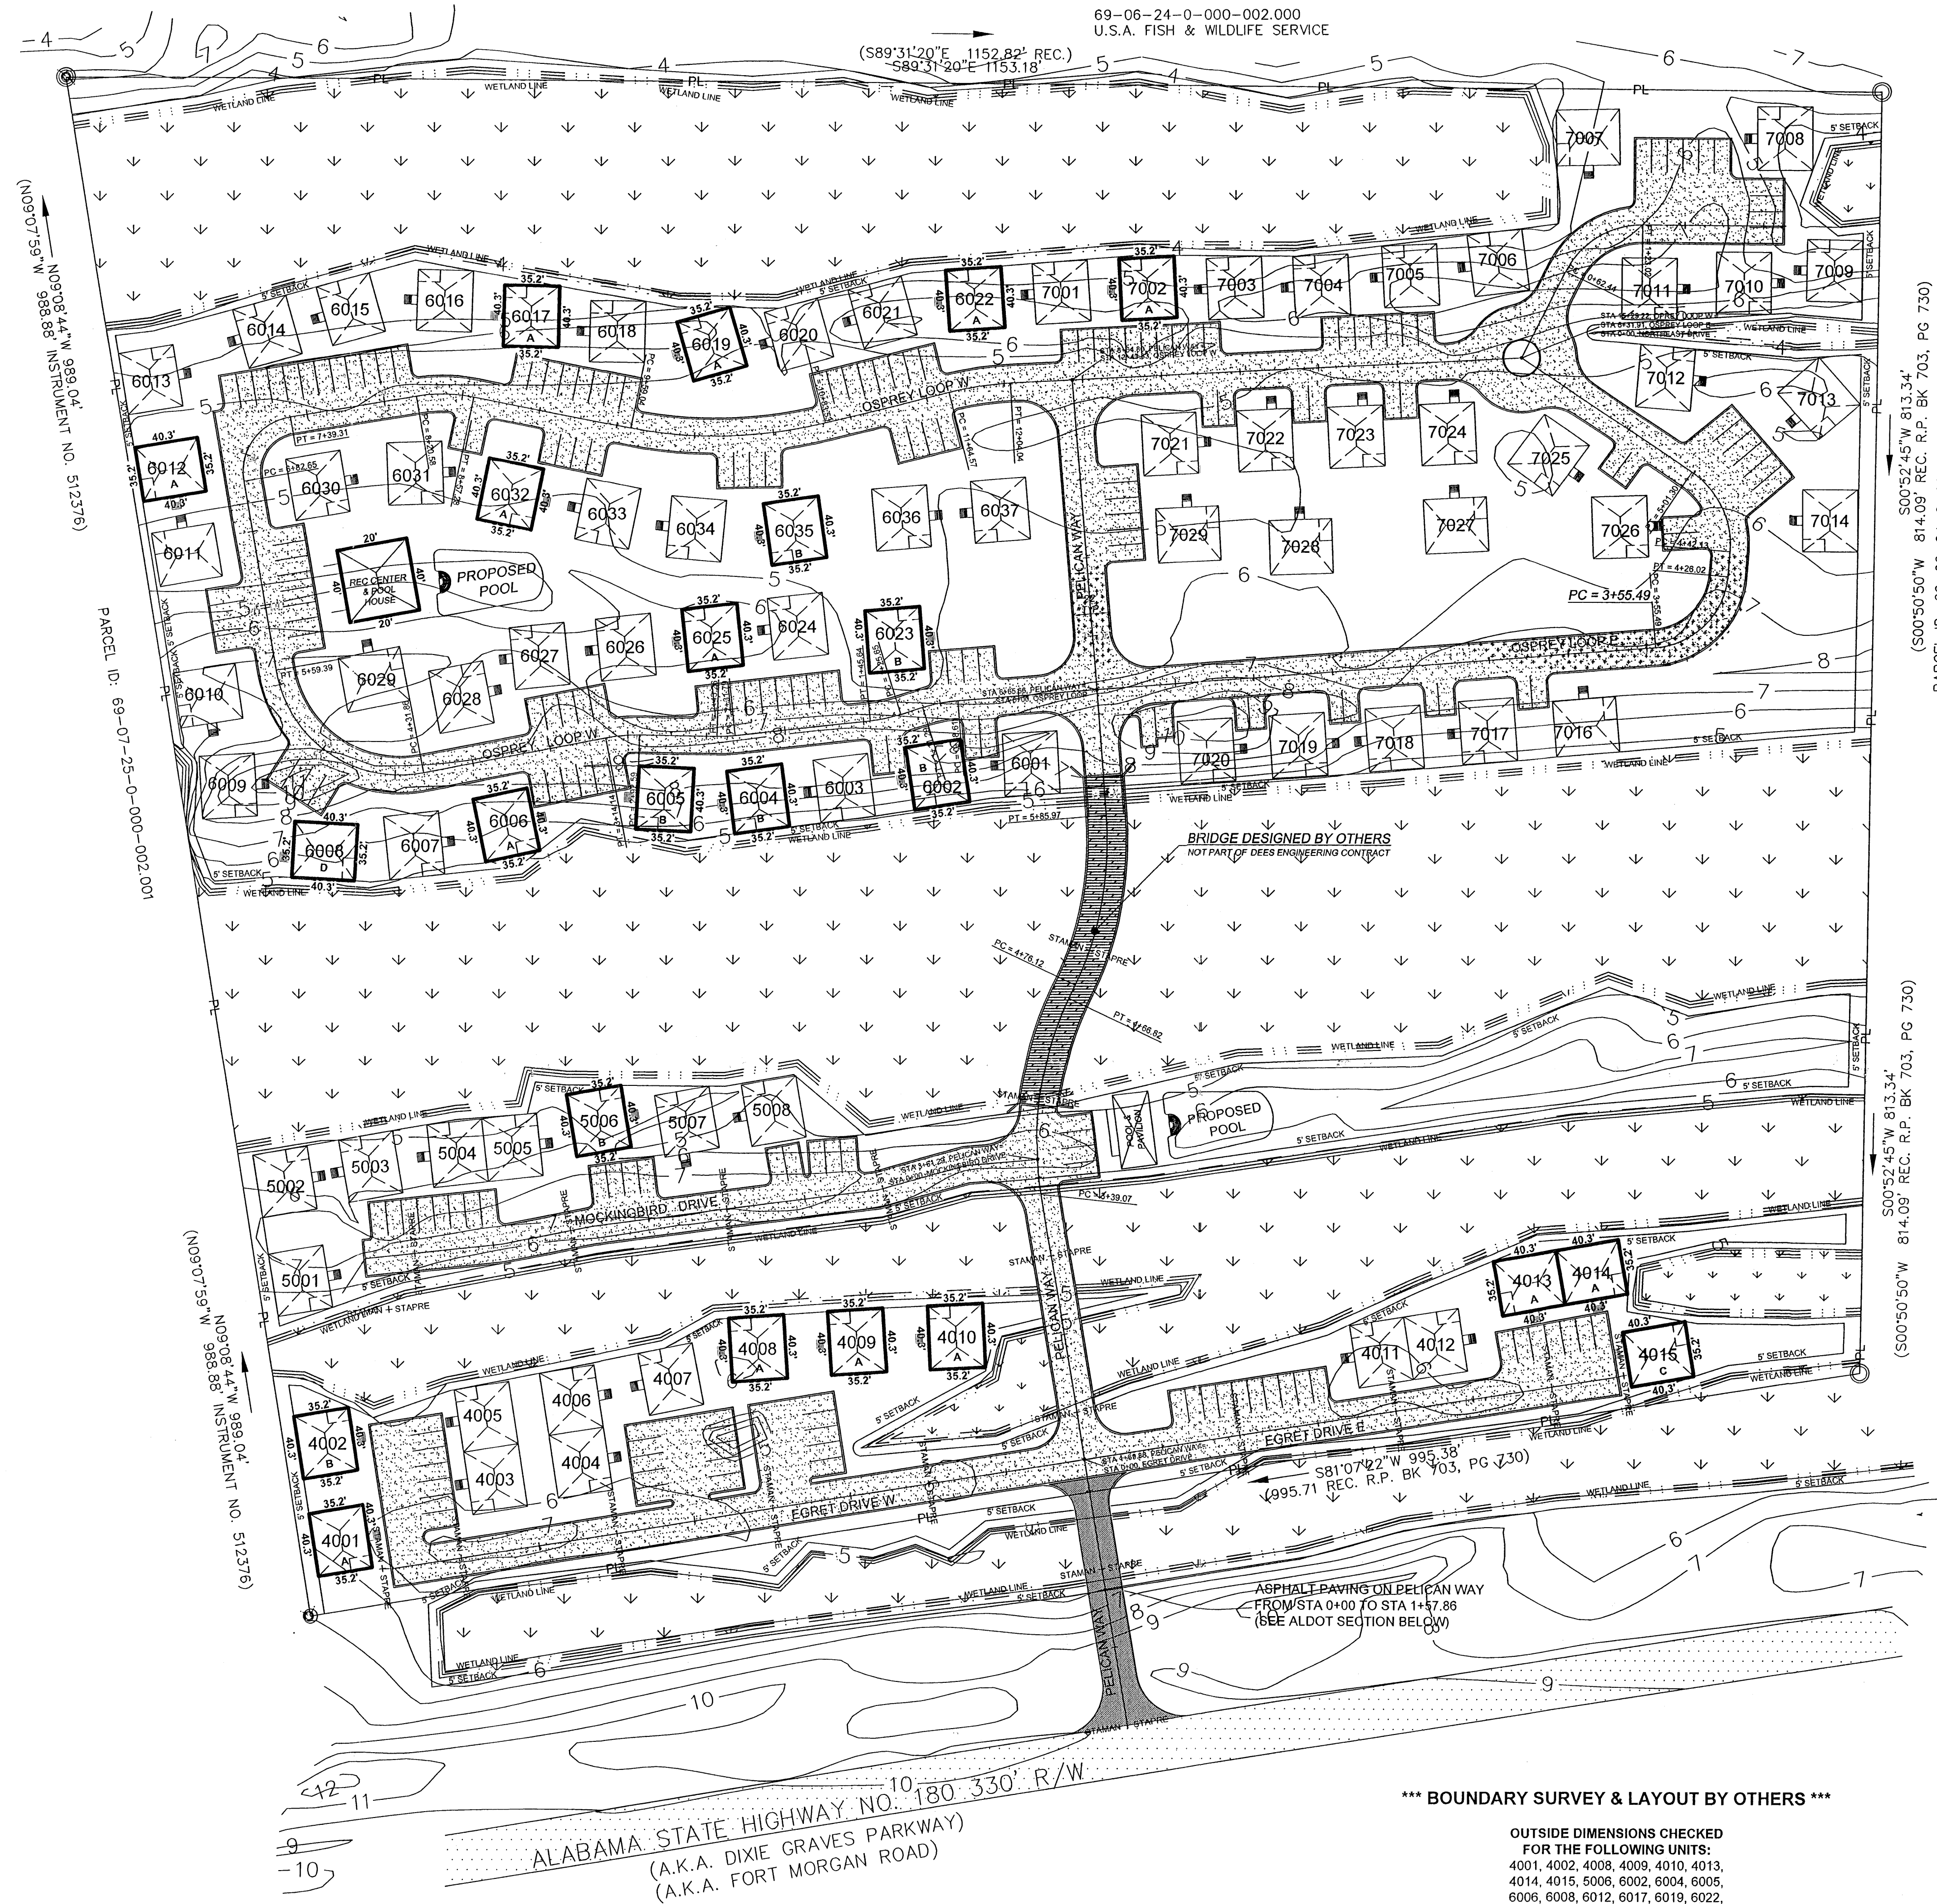

*** BOUNDARY SURVEY & LAYOUT BY OTHERS ***

OUTSIDE DIMENSIONS CHECKED
FOR THE FOLLOWING UNITS:
4001, 4002, 4008, 4009, 4010, 4013,
4014, 4015, 5008, 6002, 6004, 6005,
6006, 6008, 6012, 6017, 6019, 6022,
6023, 6025, 6032, 6035, 7002, and
REC CENTER & POOL HOUSE

BUILDING DIMENSIONS MEASURED & CERTIFIED BY BORDEN
ENGINEERING & SURVEYING CO., INC.
Richard C. Borden, P.E. & P.L.S. 06/06/08 Date

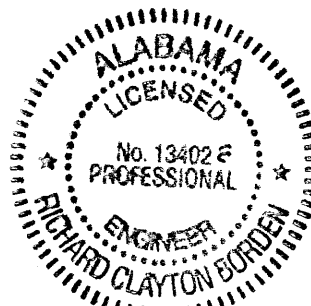

**DRAWING NOT VALID UNLESS
STAMPED WITH ENGINEER'S
STAMP IN RED INK**

The Rookery 3
Gulf Shores, Alabama