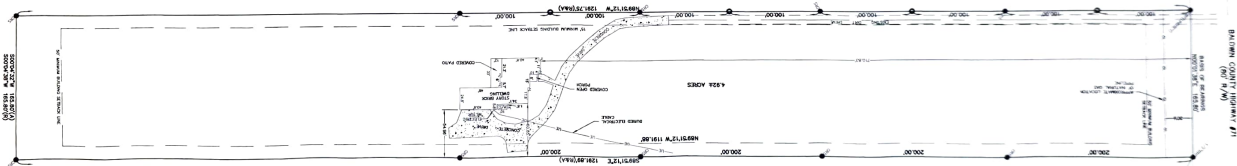


1

[illegible]

BALTIMORE COUNTY HIGHWAY 87
(60' R/W)
87
BALTIMORE COUNTY
DEPARTMENT OF PUBLIC WORKS
1400 WEST LAMAR AVE
BALTIMORE, MD 21201-1000

29°01'38"N 142°02'

WINTER 2005

7000' OF COMMISSION
NORTHWEST CORNER OF
SECTION 4
T1, R10N27E S. SOUTH
EAST, BALDWIN COUNTY, ALABAMA

LOCAL NORTH

GRAPHIC SCALE

LEGEND

- CHS 1/2" CARPRED REBAR SET (CA0089.5)
- BR CARPRED REBAR FND
- BR REBAR FOUND (NO CAP)
- CAL CALCULATED POINT
- (A) ACTUAL BEARING ON DISTANCE
- (B) RECORD BEARING ON DISTANCE
- WOOD STAKE SET
- HUB & TACK SET


McCroy Williams

1024-B STANTON ROAD
DAPHNE, ALABAMA
36526
PHONE: (251) 625-2072
FAX: (251) 621-4040
EMAIL: daphne@mcnic.com

as-built.DWG
P6688-1001

SECTION 21, TOWNSHIP 5 SOUTH, RANGE 4 EAST, BALDWIN COUNTY, ALABAMA	DATE: April 22, 2006	DRAWN BY: CML	APPROVED BY:	SHEET: 1 OF 3
---	----------------------	---------------	--------------	---------------


*AS BUILT SURVEY
FOR
SCOTT POOLE

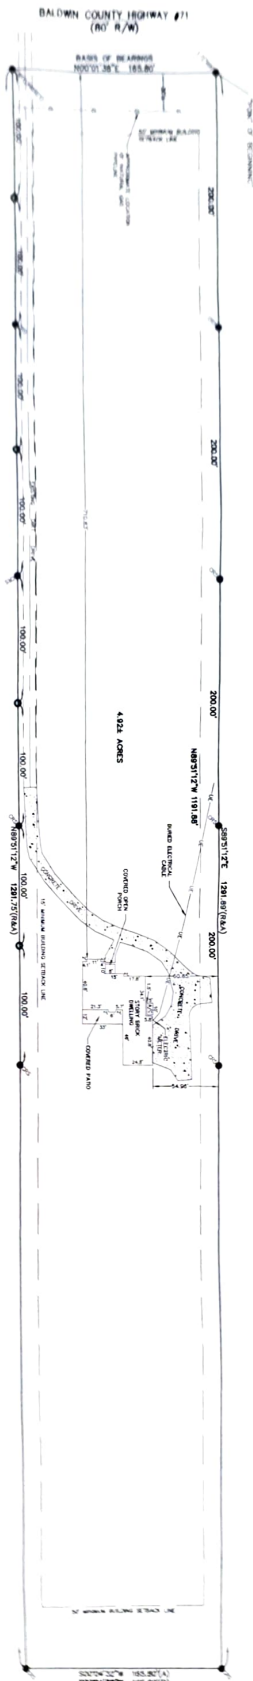[illegible][illegible]

附(2) 附(3) 附(4)
附(5) 附(6) 附(7)



LOCAL NORTH

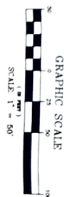

LEGEND

- COR 1/2" CAPPED REBAR SET (CADDINGS)
- COR CAPPED REBAR FOUND
- REBAR FOUND (NO CAP)
- CAL. CALCULATED POINT
- (A) ACTUAL BEARING OR DISTANCE
- (B) RECORD BEARING OR DISTANCE
- WOOD STAKE SET
- HUB & TACK SET