


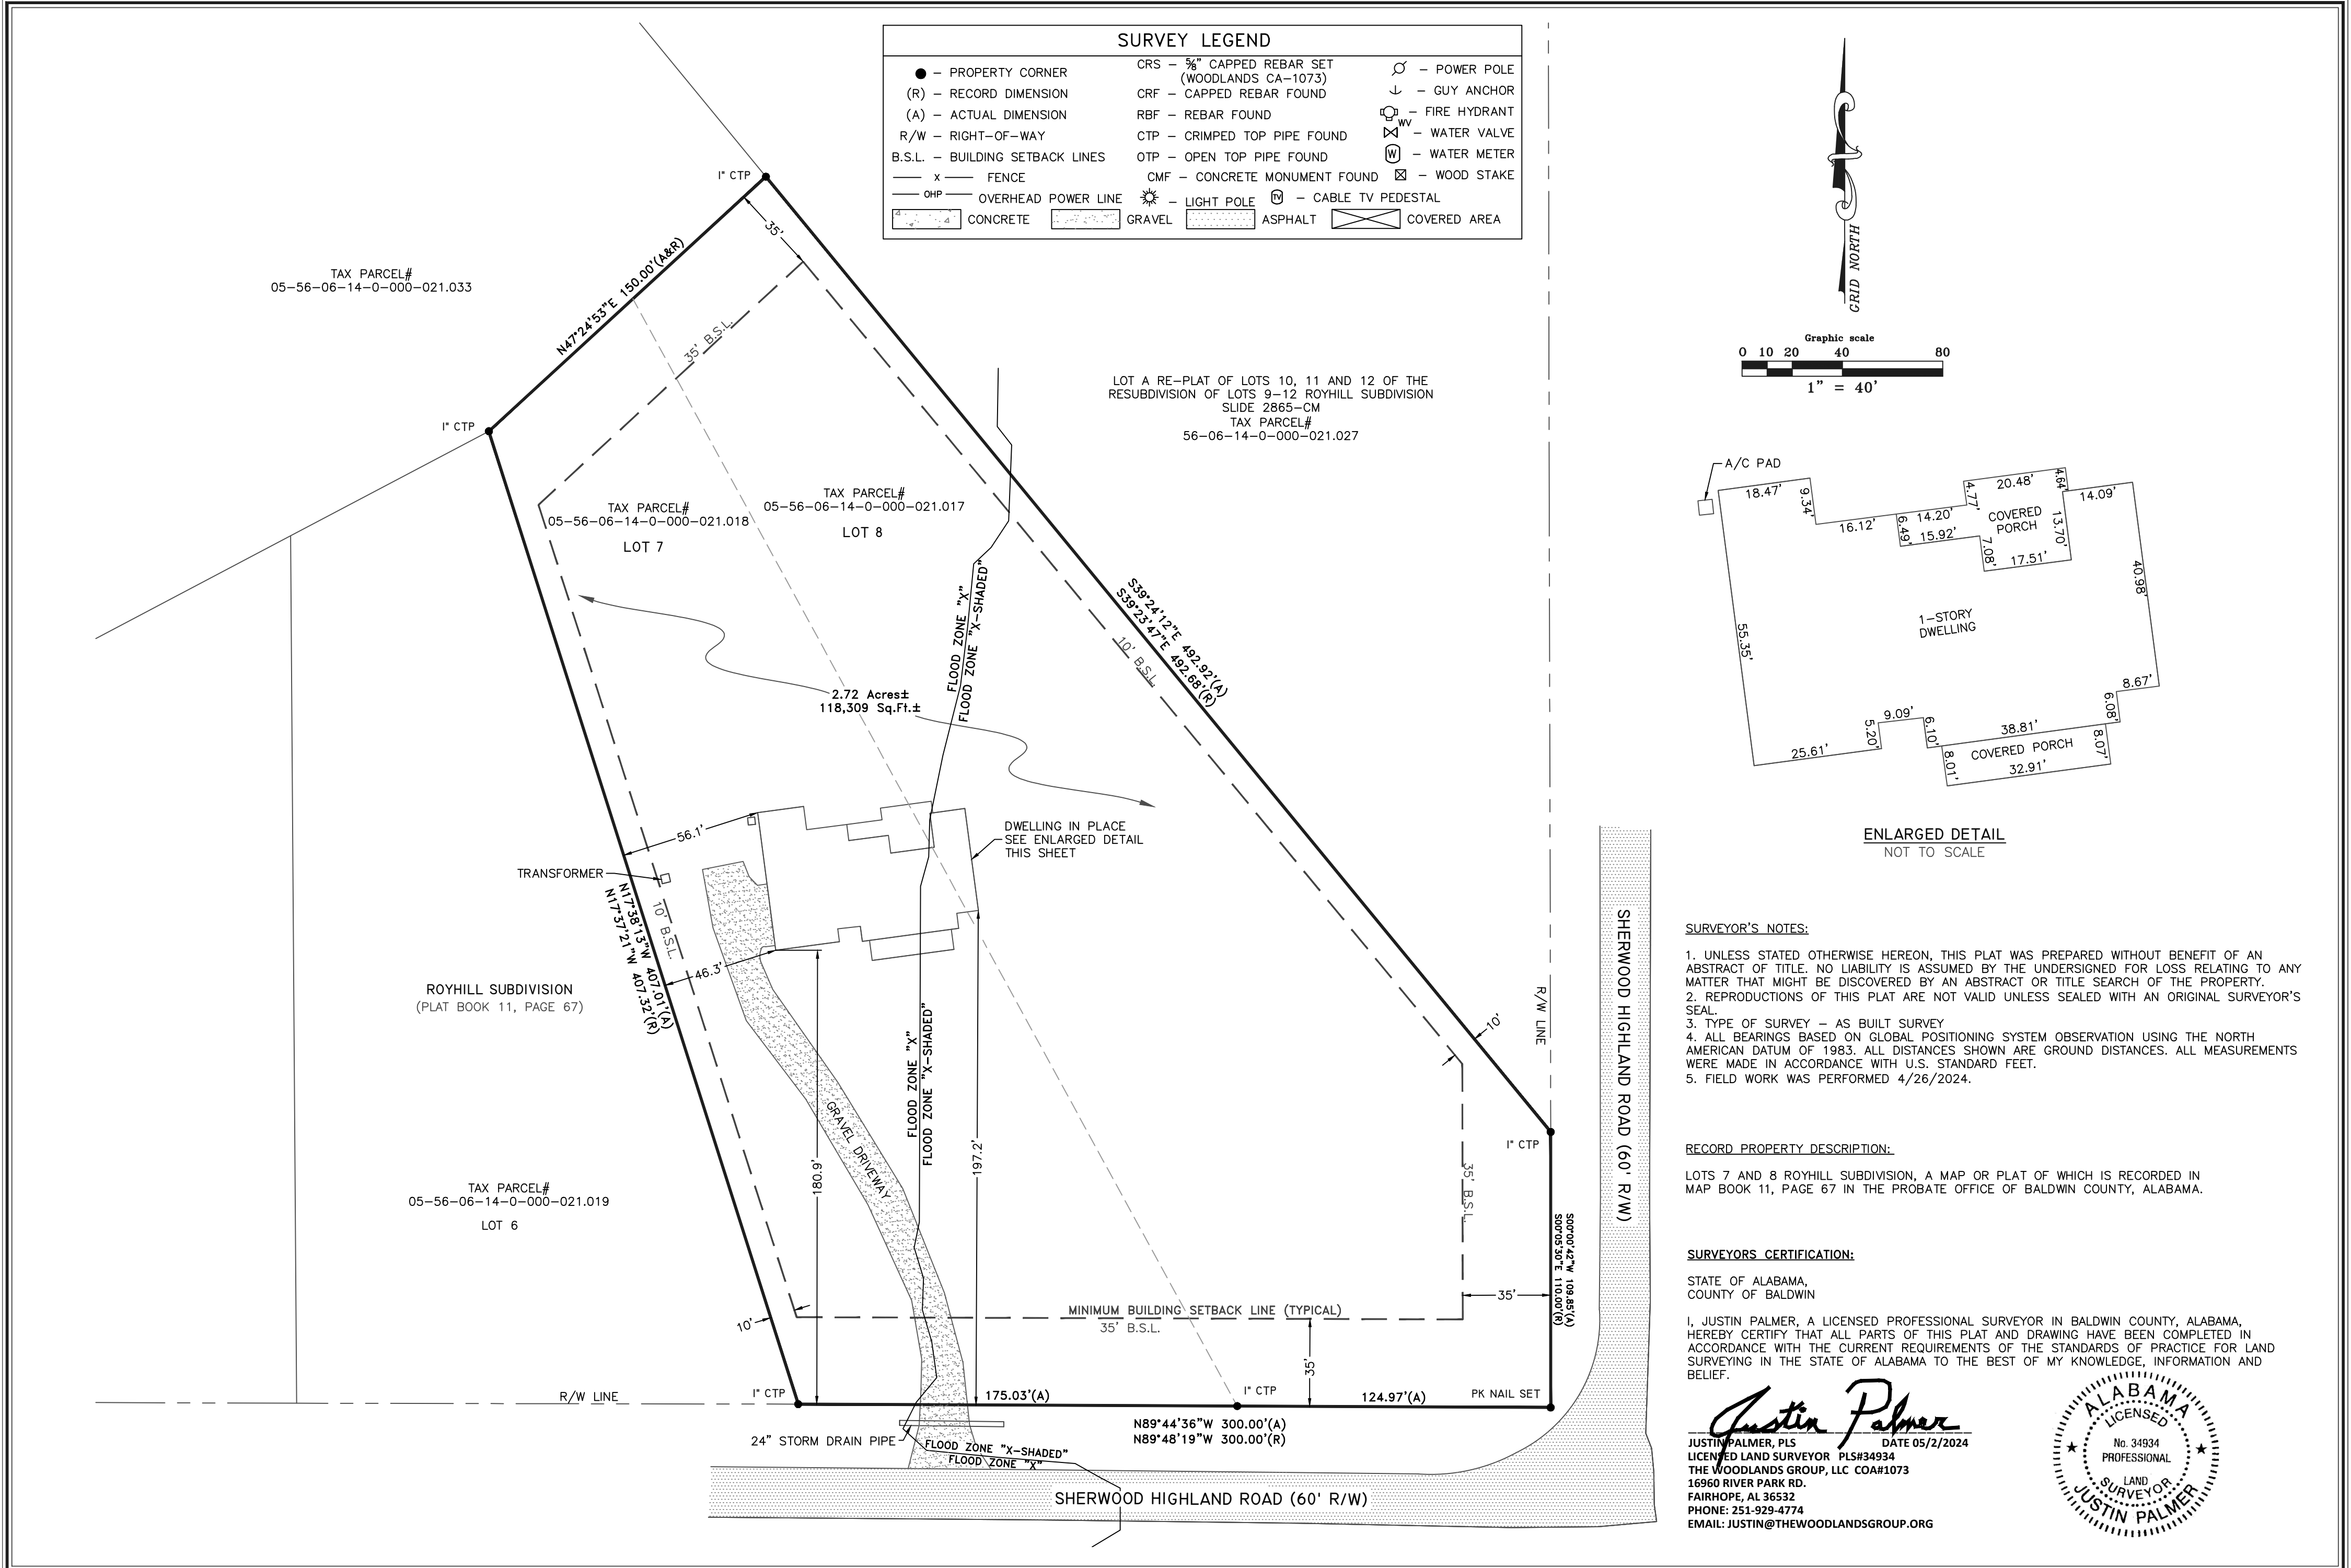

REFERENCE MATERIAL	DATE	AS BUILT SURVEY LOTS 7 & 8 ROYHILL SUBDIVISION SHERWOOD HIGHLAND ROAD BALDWIN COUNTY, ALABAMA SECTION-14, TOWNSHIP-7-SOUTH, RANGE-2-EAST	
1. RECORD PLAT OF ROYHILL SUBDIVISION - SLIDE 946B	10/22/1980		
2.			
3.			
4.			

CLIENT: TRUELOVE	DATE: 4/26/2024
FIELD WORK BY: JF, KA	DRAWING NO.: 20064
DRAWN BY: SJE	SHEET 1 OF 1
CHECKED BY: JP	
SCALE: 1" = 40'	

THE

WOODLANDS

GROUP

Surveying Solutions